

PAGE 1

Siobhan Burland Ross, M.Eng., P. Eng. A/Director Manitoba Sustainable Development Environmental Approvals 1007 Century Street Winnipeg MB R3H 0W4

March 19, 2019

Re: City of Winnipeg - Southwest Rapid Transit Corridor — Stage 2 Project

Environment Act Licence No. 3121 E. FILE NO.: 5709.00

Dear Ms. Burland Ross:


The City is requesting revision to Environmental Approvals, Licence No. 3121 E, Clause 13 which states: "The Licencee shall implement the drainage plan outlined in the report submitted to the Director of the Environmental Approvals Branch on June 18, 2015 titled "Southwest Transitway - Stage 2, Additional Information on Drainage and Natural Areas in the Parker Lands". The section of berm running east from the AT path to the north of the station and then running towards the CN property on the west side of the pond has not been built. This final section of berm, as described in the attached, is not required due to sufficient elevation to prevent drainage. We are requesting your concurrence that the highlighted berm is not required as originally presented in the June 18, 2015 report.

Yours truly,

Jesse Crowder Project Manager

Enclosure

Cc: Elise Dagdick, Manitoba Sustainable Development

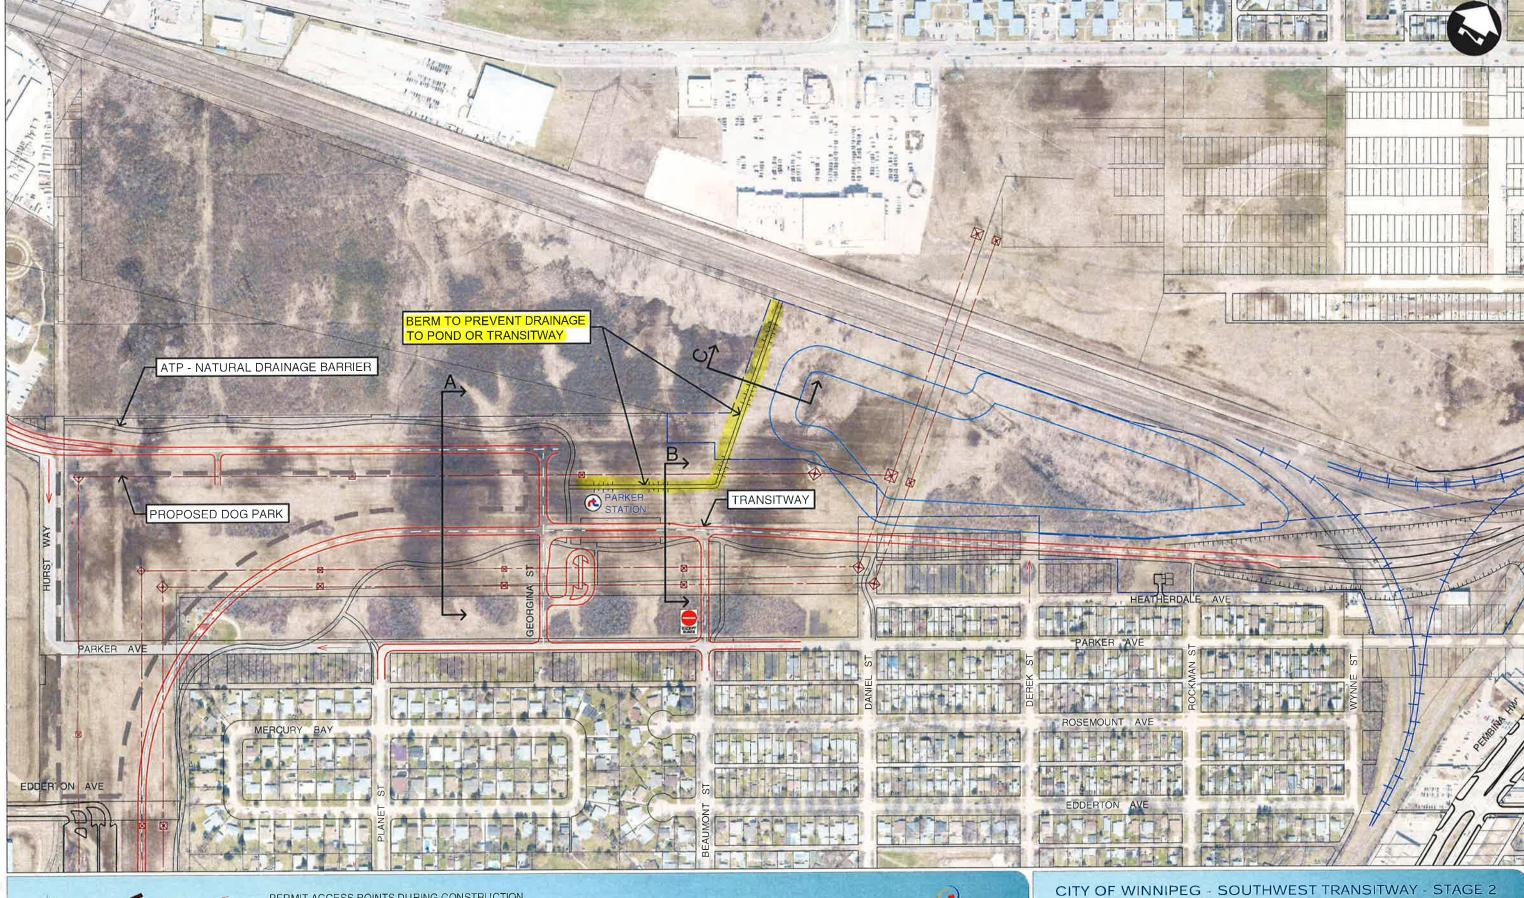


DILLONCONSULTING

PERMIT ACCESS POINTS DURING CONSTRUCTION

NOTE: OPERATIONAL ACCESS POINTS AFTER CONSTRUCTION FROM TRANSITWAY ONLY



FIGURE EIA-003
PARKER LANDS - DRAINAGE PLAN DRAWING 1 OF 2

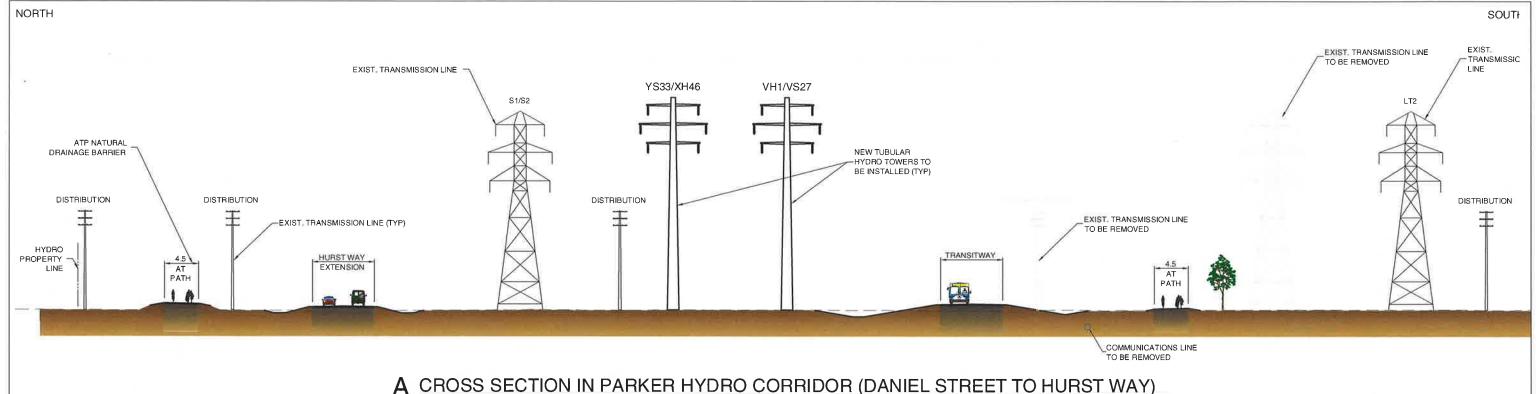


A CROSS SECTION IN PARKER HYDRO CORRIDOR (DANIEL STREET TO HURST WAY) (LOOKING EAST)

NORTH


SOUTH

WEST

EAST

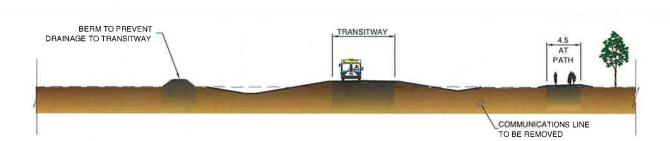

CROSS SECTION AT PARKER STATION (LOOKING EAST)

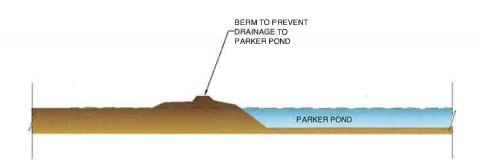

C CROSS SECTION AT PARKER POND (LOOKING NORTH)





CITY OF WINNIPEG - SOUTHWEST TRANSITWAY - STAGE 2

March 15, 2019



City of Winnipeg Transit Department 421 Osborne Street Winnipeg, Manitoba R3L 2A2

Attention: Jesse Crowder, M.Sc., P.Eng.

City of Winnipeg Southwest Rapid Transit Corridor (Stage 2) Project Environment Act Licence No. 3121 E. CLIENT FILE NO.: 5709.00

Dear Mr. Crowder:

In response to your request, Dillon Consulting Limited (Dillon) is pleased to provide the following documentation with respect to seeking an amendment to Environment Act Licence No. 3121 E Clause 13.

Environmental Approvals, Licence No. 3121 E, Clause 13 states: "The Licencee shall implement the drainage plan outlined in the report submitted to the Director of the Environmental Approvals Branch on June 18, 2015 titled "Southwest Transitway - Stage 2, Additional Information on Drainage and Natural Areas in the Parker Lands"". To date, the contractor (PCL) has built the Active Transportation (AT) path from the Humane Society (far left on Figure EIA-003, attached) parallel to Hurst Way to the north and then parallel to Georgina Street to the east and tying it into the Beaumont Station (which is labelled Parker Station on Figure EIA-003 as this drawing was produced prior to the name change). The section of berm running east from the AT path to north of the station and then running towards CN property on the west side of the pond has not been built (highlighted on Figure EIA-003).

In addition, the owner of the lands to the north of the AT path (known as the GEM lands) has cleared all the trees on their property and has brought in thousands of cubic metres of fill material. This has significantly changed the natural features and use of the area.

Dillon has assessed the construction progress along with the recent information provided by the contractor. Based on this review, Dillon is in agreement that the final section of berm (highlighted on Figure EIA-003) is not required due to sufficient elevation to prevent drainage as well as the changes to the surrounding lands.

1558 Willson Place

Winnipeg

Manitoba

Canada

R3T 0Y4

Telephone

204.453.2301

Fax

204.452.4412

City of Winnipeg Page 2 March 15, 2019



This information has been discussed with Ms. Elise Dagdick of Manitoba Sustainable Development in December with follow-up in January. Ms. Dagdick understands our position that there is no further benefit in constructing the final section of berm to prevent drainage out of the GEM lands. She has indicated that her department is prepared to receive and review this request to amend Environmental Approvals, Licence No. 3121 E, Clause 13 in accordance with Figure EIA-003, deleting the berm highlighted on the drawing.

If you have any questions about this information please contact the undersigned.

Yours sincerely,

DILLON CONSULTING LIMITED

Taran Peters, P.Eng.
Partner, Project Manager

TJP/knp

Attachment: Figure EIA – 003: Parker Lands – Drainage Plan

Our file: 16-3611

1558 Willson Place

Winnipeg

Manitoba

Canada


R3T 0Y4

Telephone

204.453.2301

Fax

204.452.4412

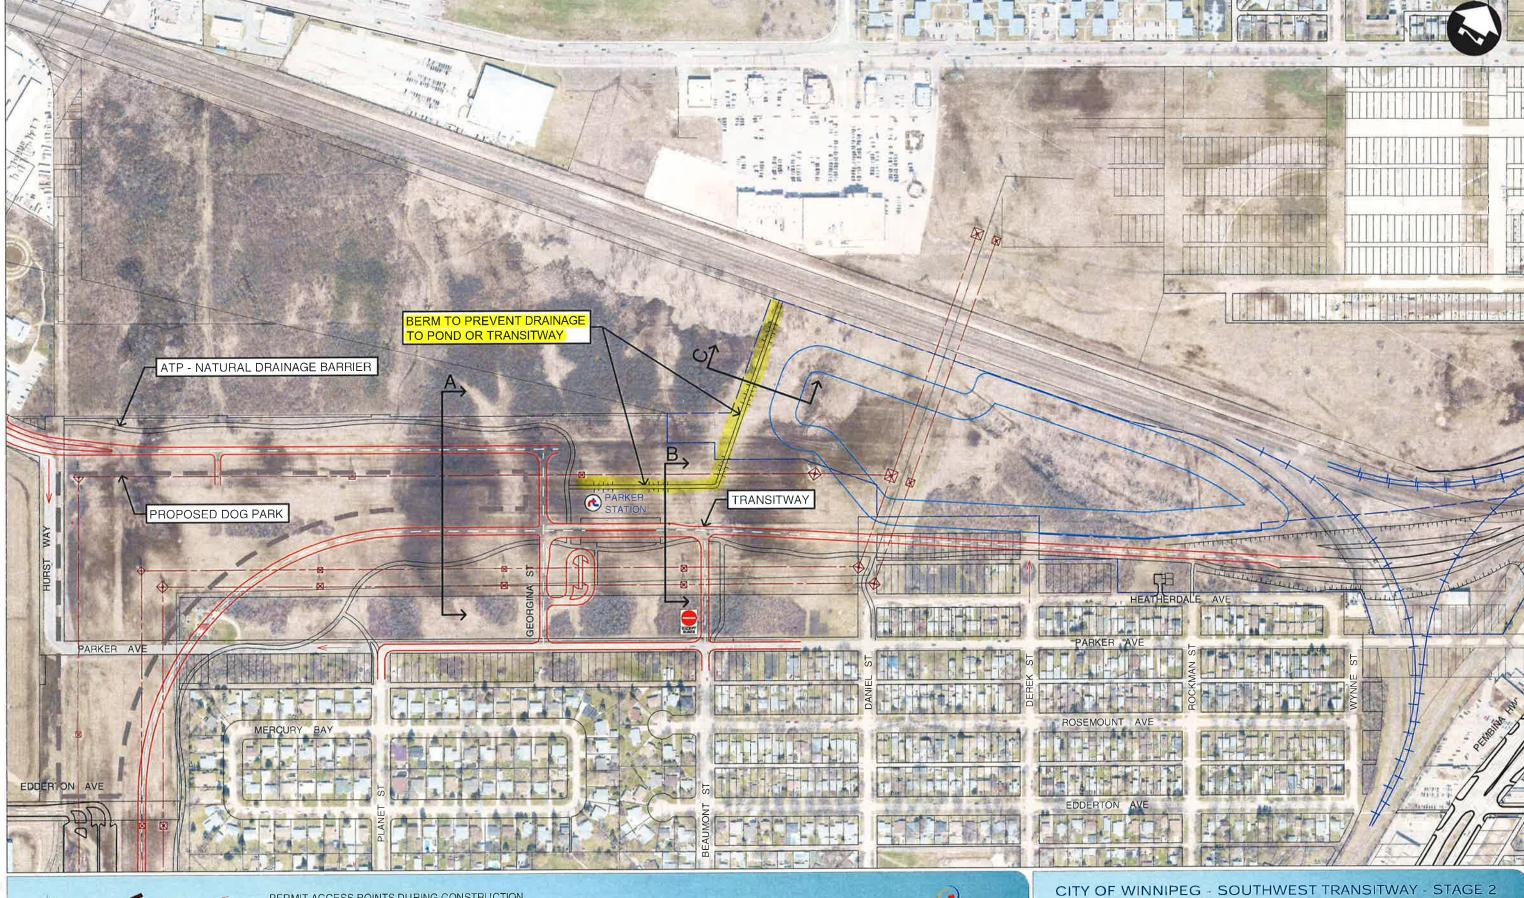

DILLONCONSULTING

PERMIT ACCESS POINTS DURING CONSTRUCTION

NOTE: OPERATIONAL ACCESS POINTS AFTER CONSTRUCTION FROM TRANSITWAY ONLY



FIGURE EIA-003
PARKER LANDS - DRAINAGE PLAN DRAWING 1 OF 2